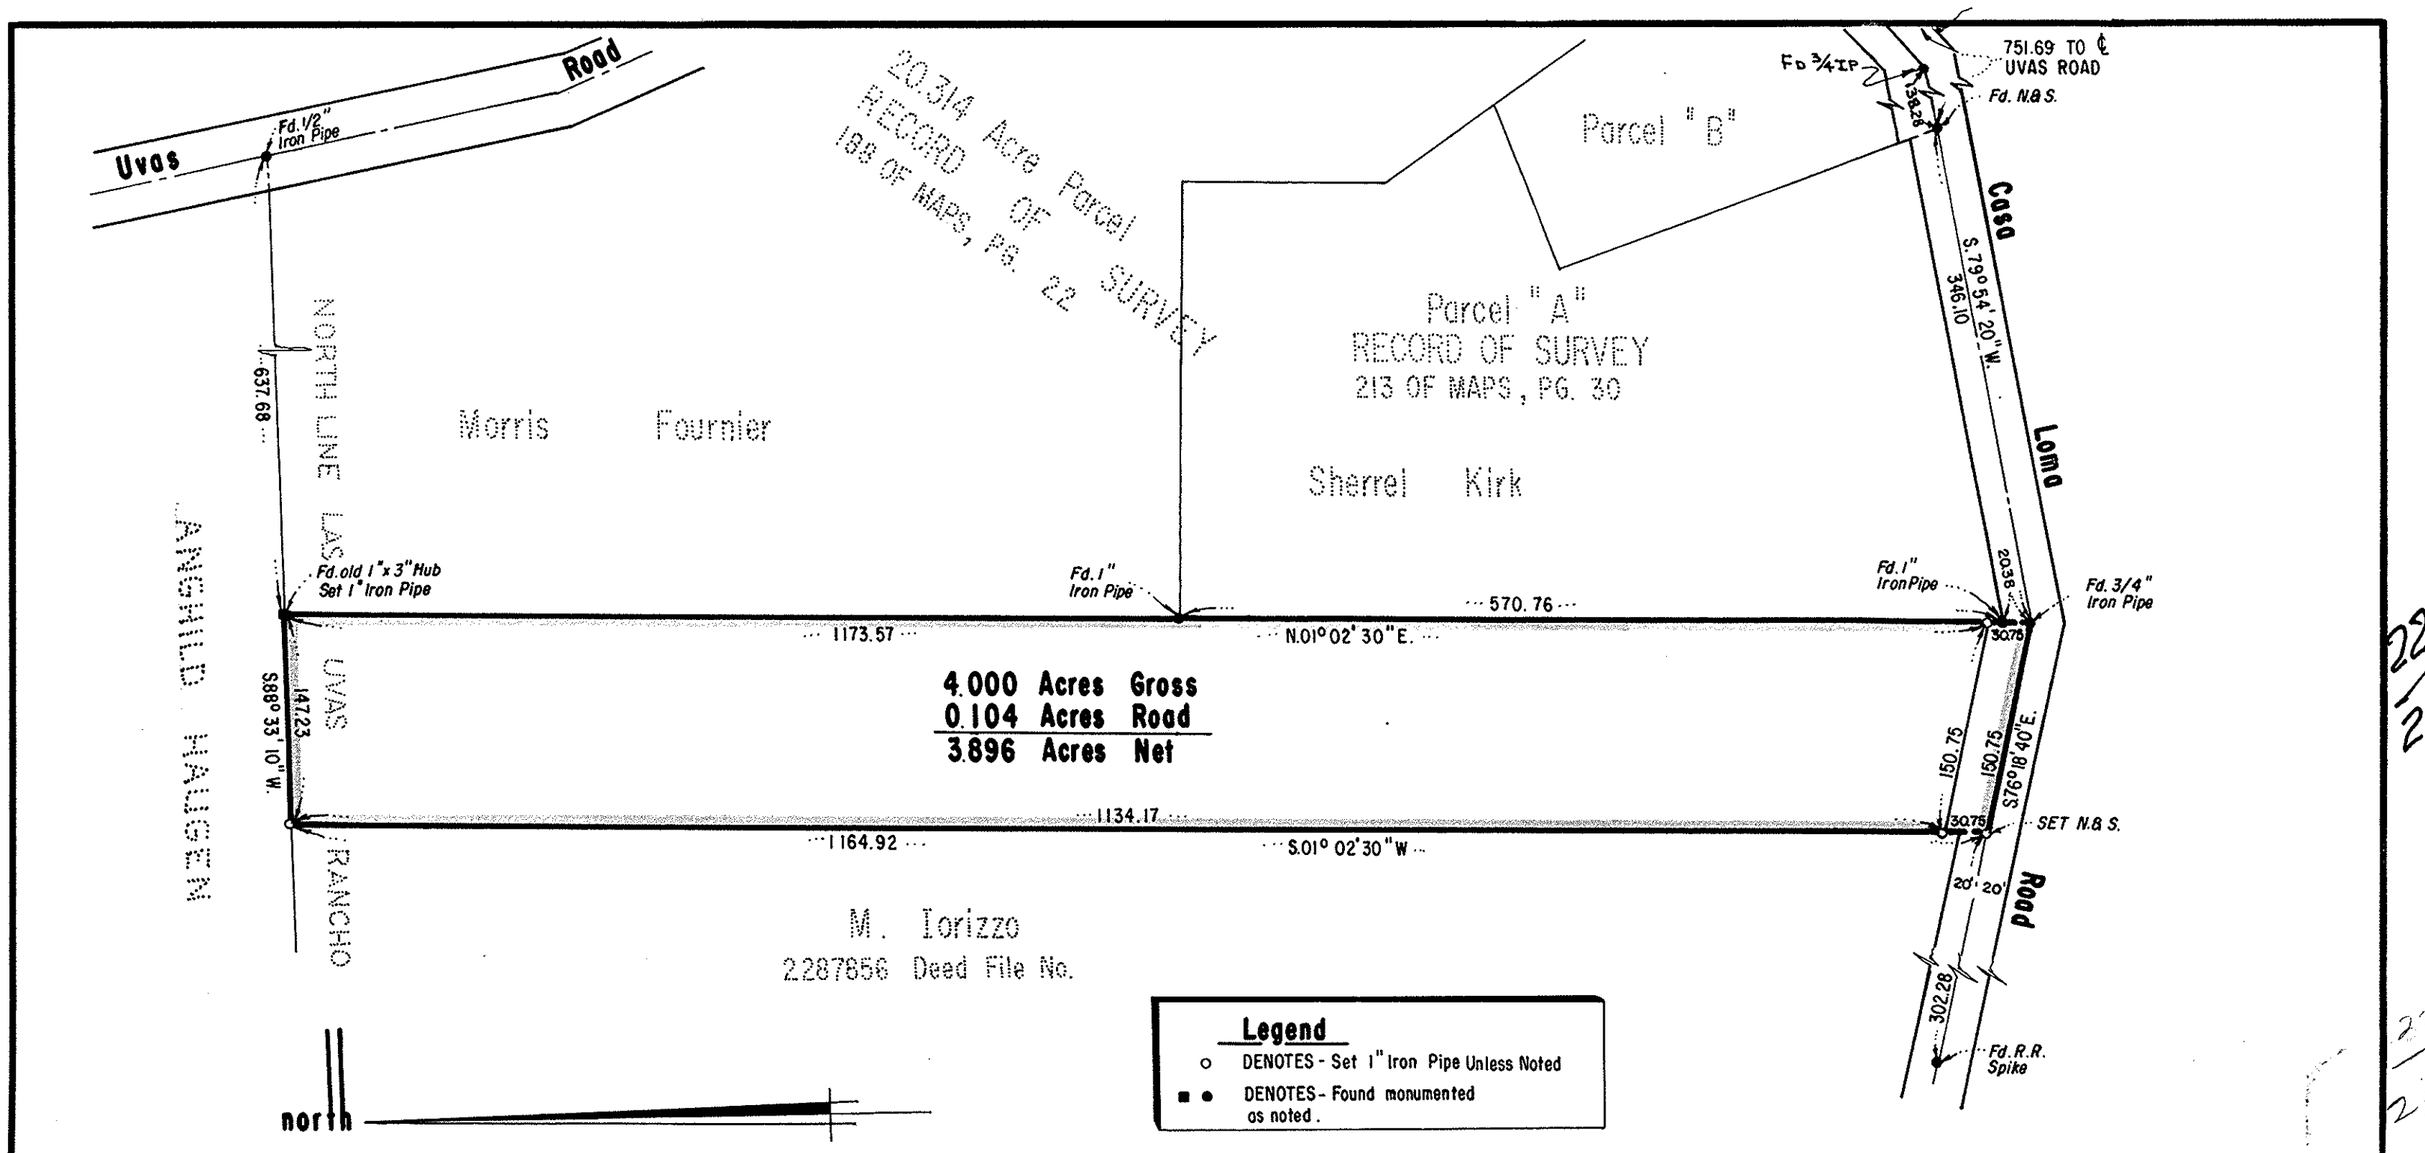

Basis of Bearing

The bearings shown on this map are based on that portion of Casa Loma Road that was found monumented and recorded as S.79°54'20"W., in Book 213 of Maps, Page 30 - Santa Clara County Records.

#3285741

SURVEYOR'S CERTIFICATE

This map correctly represents a survey made by me or under my direction in conformance with the requirements of the Land Surveyors' Act at the request of CHARLES SPAULDING
Name of Person Authorizing Survey
in SEPT., 1966.

(Signed and sealed) Walter J. Hanna Jr.
L.S. (~~or R.C.E.~~) No. 2550

CO. SURVEYOR'S CERTIFICATE

This map has been examined for conformance with the requirements of the Land Surveyors' Act this 14th day of September, 1967.

JAMES T. POTT
County Surveyor

By Diane P. Larson
Deputy

RECORDER'S CERTIFICATE

Filed for record this 14th day of SEPT, 1967, at 3:40 P.m. in Book 228 of MAPS at page 21, at the request of Walter J. Hanna Jr.

$5.00

GEORGE E. FOWLES
County Recorder

By Ralph Ulatt
Deputy

RECORD of SURVEY

PORTION OF LOT 2
MORGAN HILL RANCH MAP NO. 4
Santa Clara County, Calif.

Sept. 1966 Scale: 1" = 100'

W. J. HANNA & SON
Civil Engineers & Surveyors
Gilroy, California

J.N. 6595
BK. 200/202

228/21

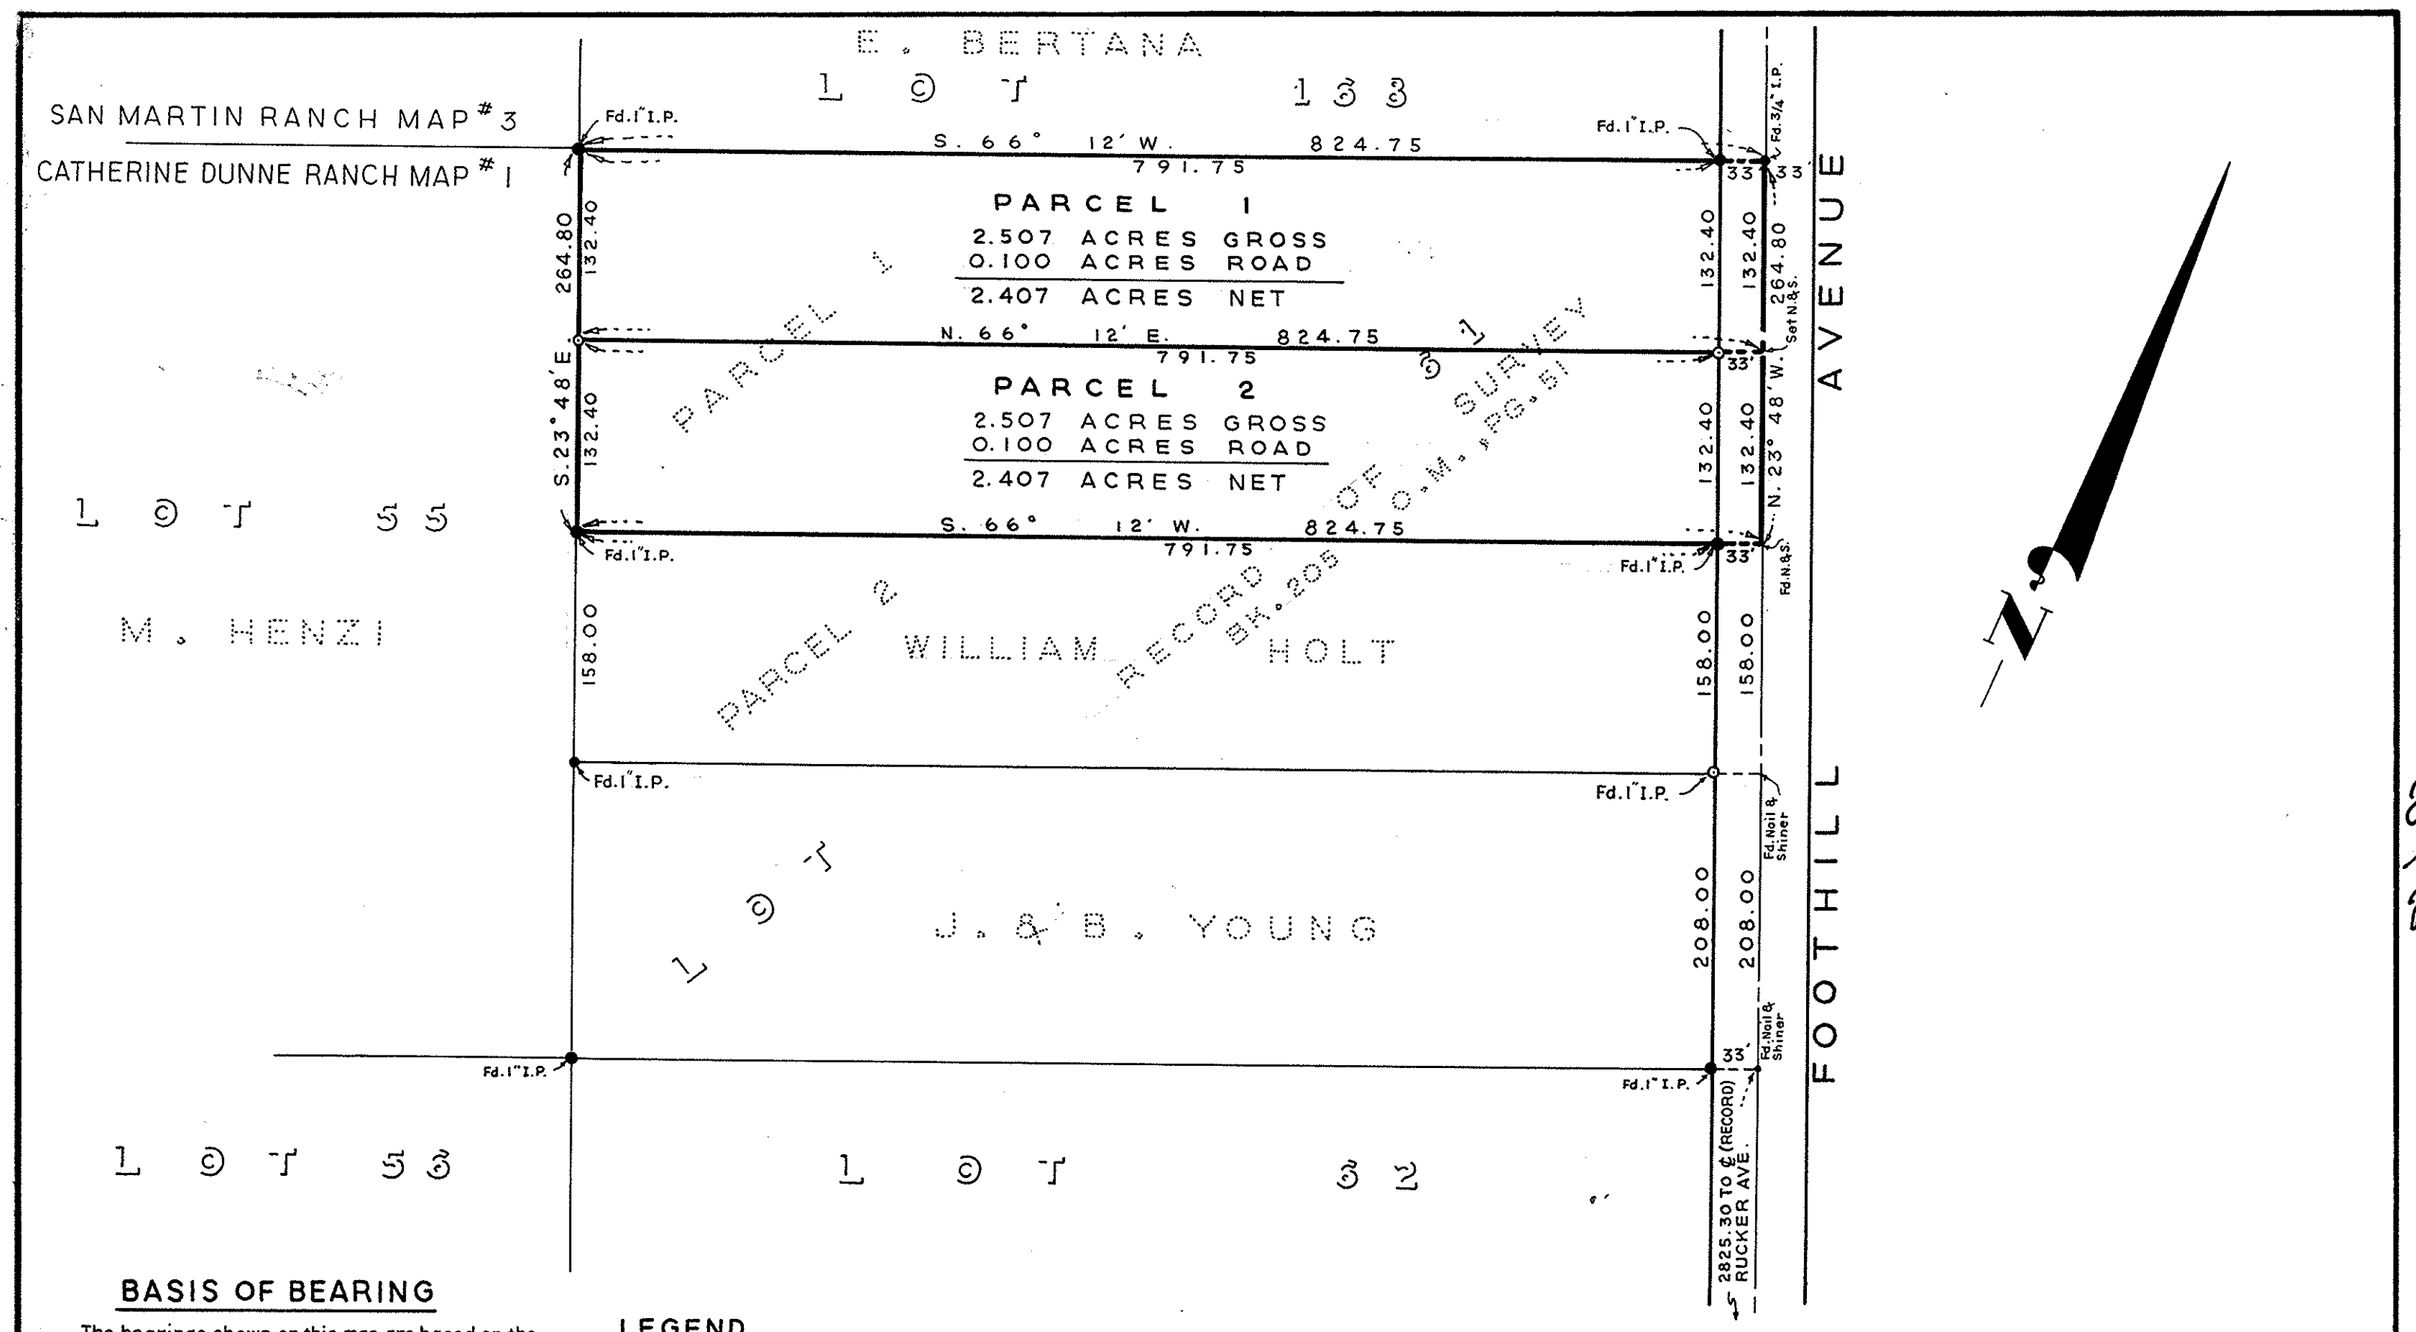

BASIS OF BEARING

The bearings shown on this map are based on the Southeasterly line of Lot 61 as found monumented and recorded as S.66°12'W., in Book "G" Of Maps, Pages 92 & 93 Santa Clara County Records.

SURVEYOR'S CERTIFICATE

This map correctly represents a survey made by me or under my direction in conformance with the requirements of the Land Surveyors' Act at the request of William Holt
Name of Person Authorizing Survey
in August, 1967.

(Signed and sealed) Walter J. Hanna Jr.
L.S. (~~or R.C.E.~~) No. 2550

LEGEND

○ ---- Denotes 1" Iron Pipe Set.
● ---- Denotes Found Monuments As Noted.

CO. SURVEYOR'S CERTIFICATE

This map has been examined for conformance with the requirements of the Land Surveyors' Act this 14th day of September, 1967.

James T. Pott
County Surveyor

By Diane P. Larson
Deputy

#3285742

RECORDER'S CERTIFICATE

Filed for record this 14th day of SEPT, 1967, at 3:40 P.m. in Book 228 of Maps at page 21, at the request of Walter J. Hanna Jr.

$5.00

George E. Fowles
County Recorder

By Ralph Ulatt
Deputy

RECORD OF SURVEY

PORTION OF LOT 61
CATHERINE DUNNE RANCH MAP #1

BOOK "G" OF MAPS, PAGES 92 & 93

SANTA CLARA COUNTY, CALIF.

AUGUST, 1967 SCALE: 1" = 100'

W. J. HANNA & SON - CIVIL ENGINEERS & SURVEYORS - GILROY, CALIF.

JOB NO. 6527

228/21